


**FIRST FLOOR PLAN**  
F.F.L. 103-785 except male toilet

G1 IG

19mm 'monolux' outer skin to studwork wall as at first floor level

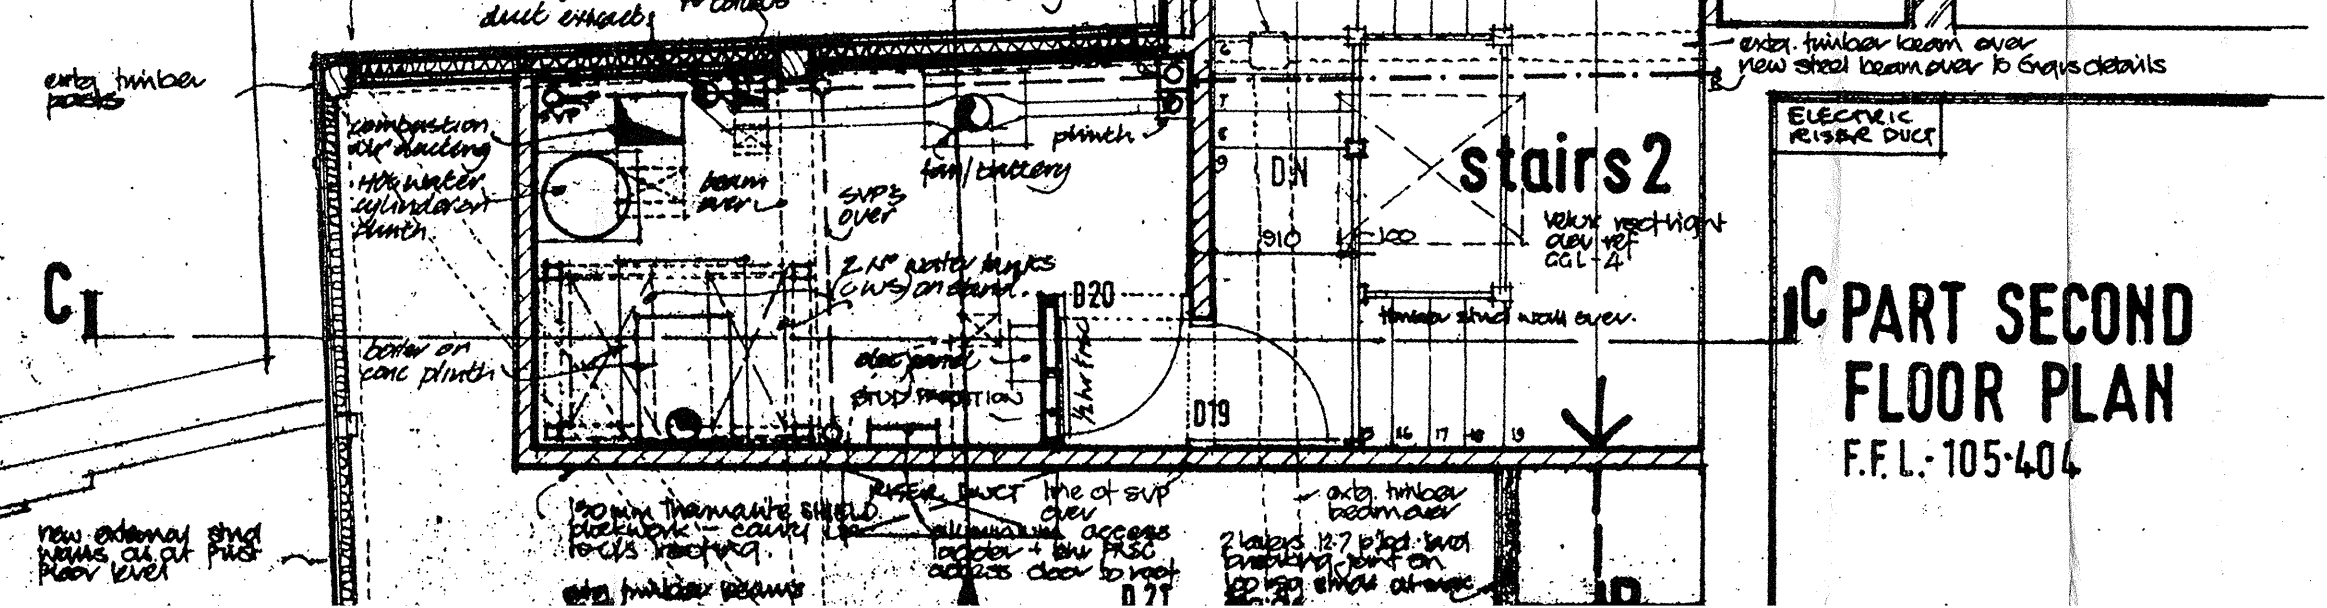

**PART SECOND FLOOR PLAN**  
F.F.L. 105-404

**AS BUILT RECORD DRAWING**

project no. 2 1025 | drawing no. 104 | rev. | drawing title  
**FIRST FLOOR PLAN**

project/client  
**PULPIT HOUSE THE SQUARE, ABINGDON.**

drawn: [signature]  
checked: [signature]  
date: 11.58